



1 Ground Floor 1:100



2 First Floor 1:100

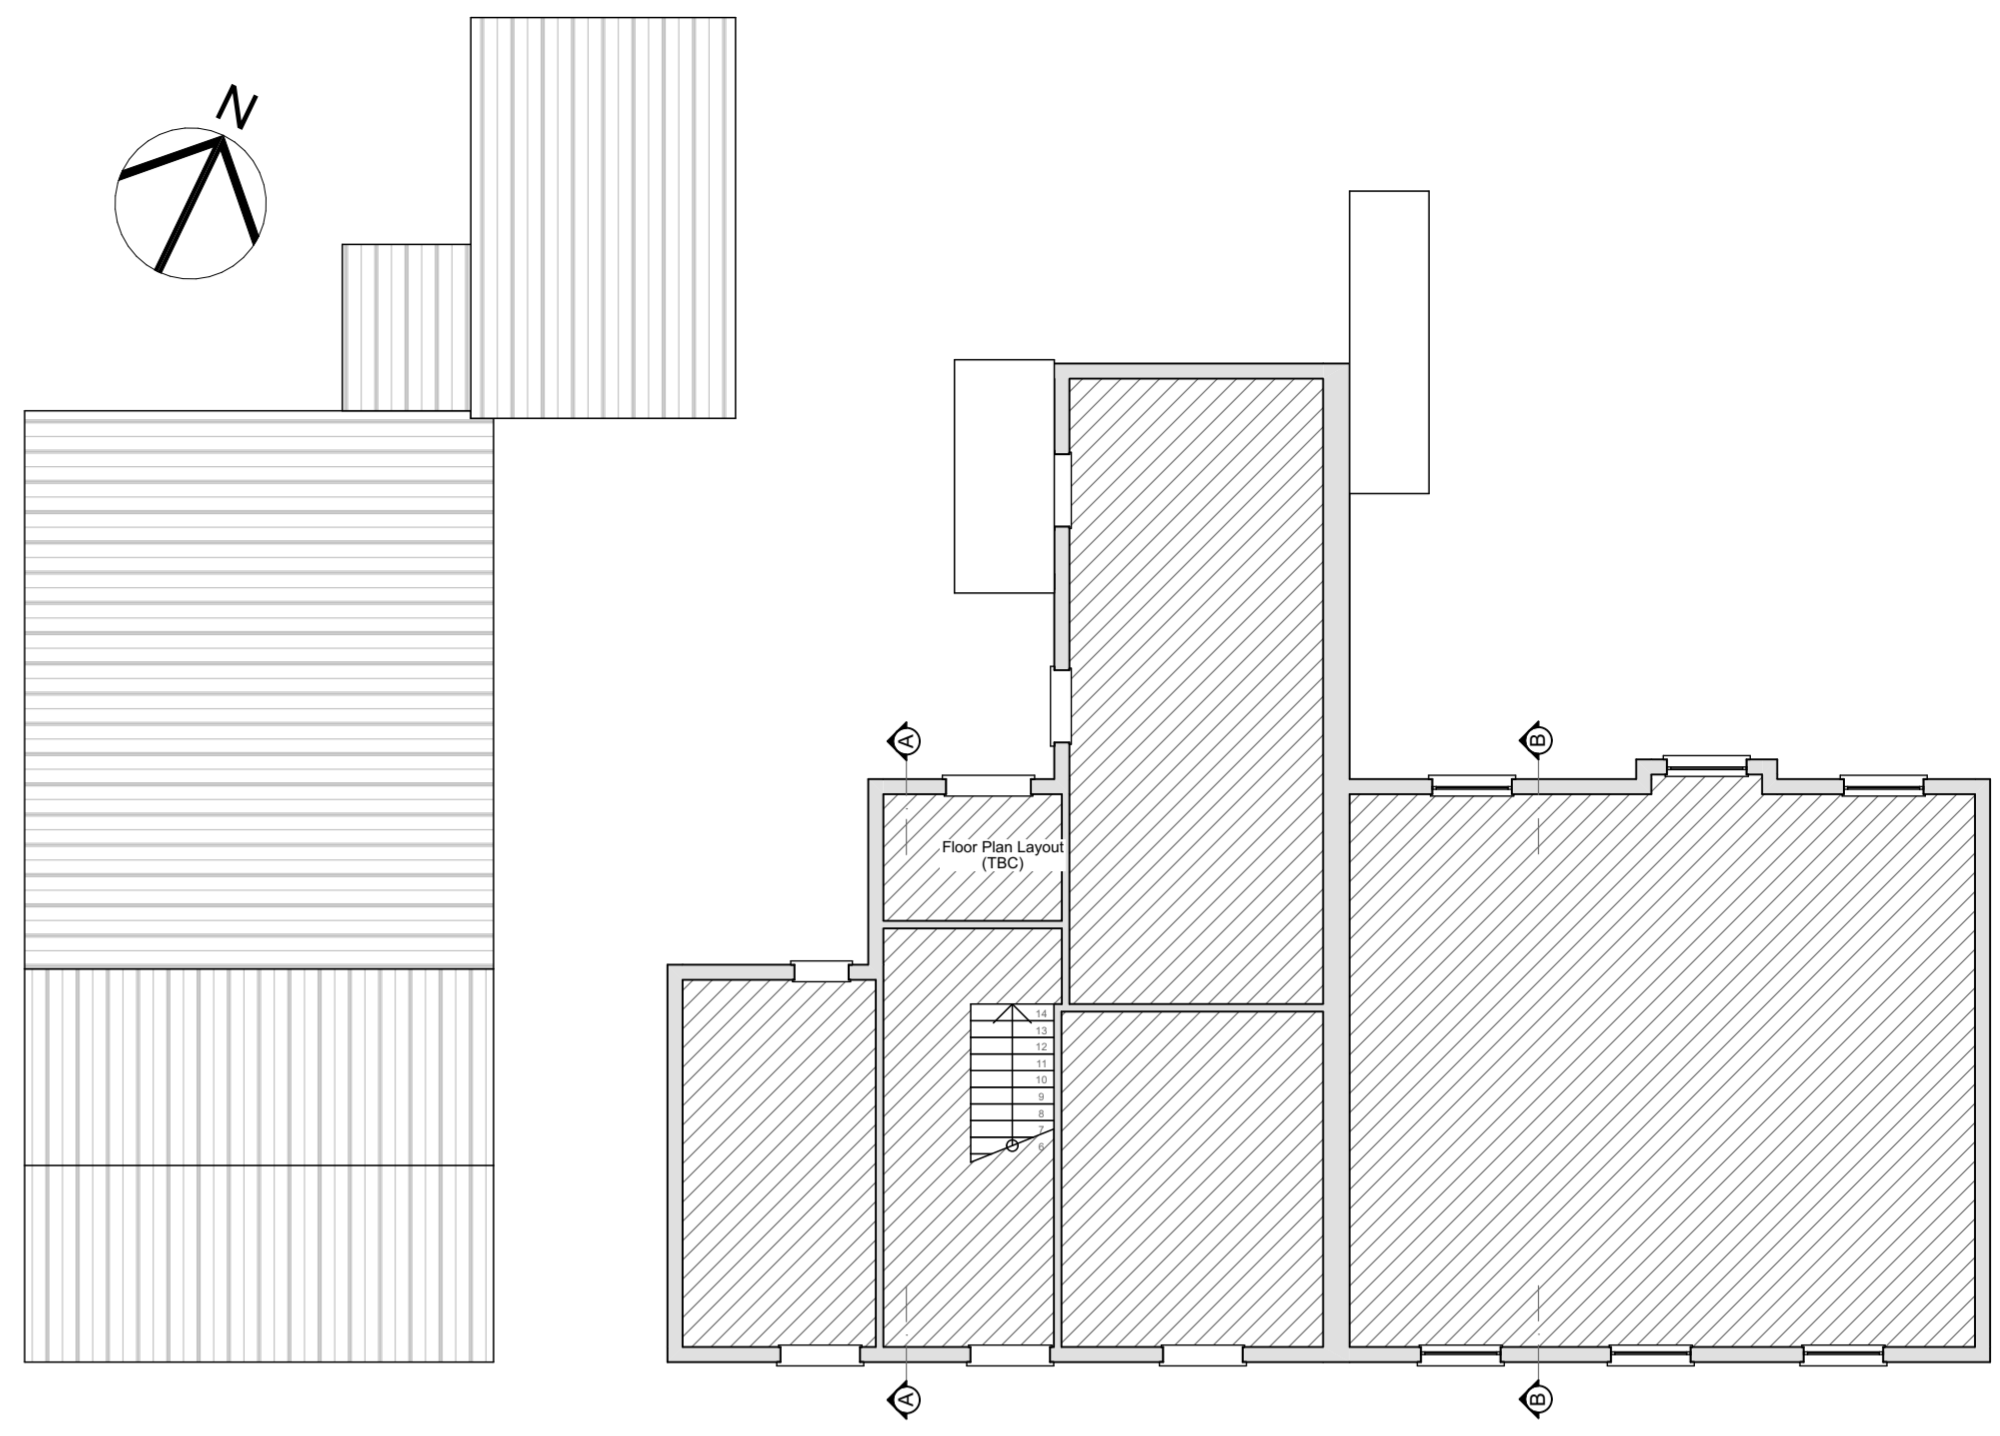


3 Front Elevation 1:100

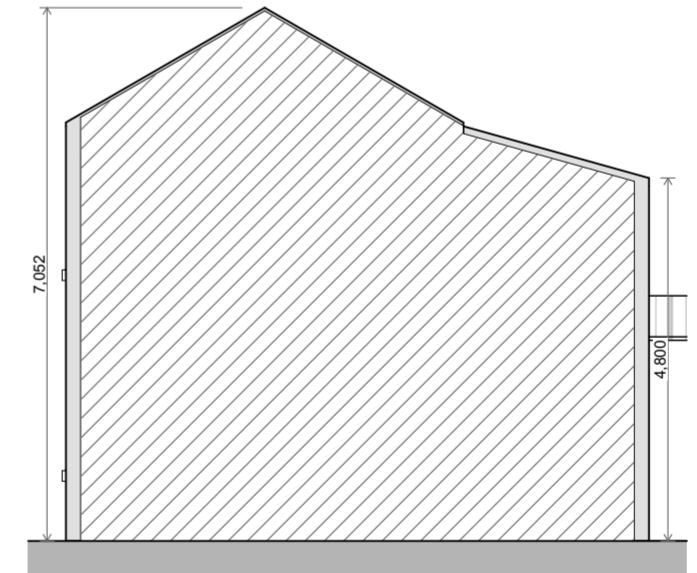

5 Section A-A 1:100



4 Rear Elevation 1:100

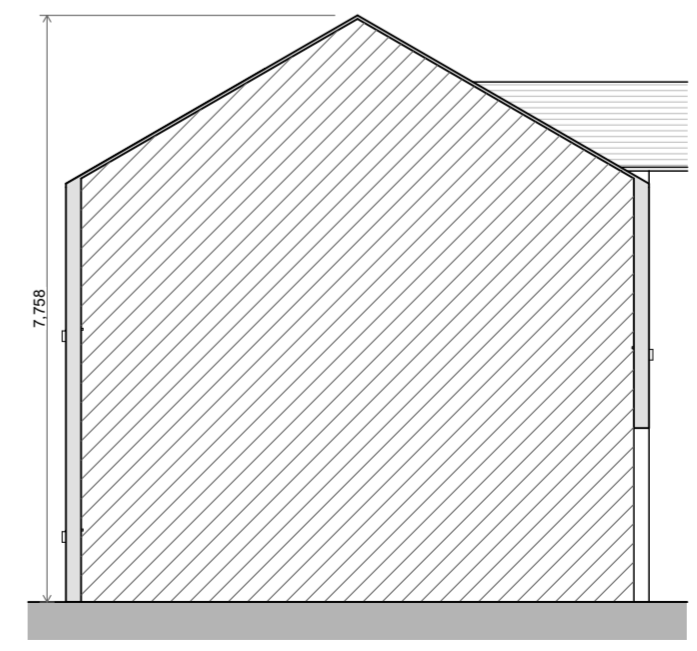

6 Section B-B 1:100



Rev	Issue Date	Description	Approved by

PART 8 PLANNING

Wynne Gormley Architects & Surveyors Ltd.

© WGG ARCHITECTS & SURVEYORS LTD
COPYRIGHT RESERVED

JOB DETAILS

'As Built' Survey of Existing Building @
Brewshill, Navan, Co. Meath for Meath County Council

Scale @ A2 1:100, 1:1	Dwg.no PL22-019-100	Amend.
Date 13/09/2022	Description Existing Drawings - Floor Plans, Elevations & Sections	
Drawn by J. McDermott		
Checked by E. Gilsenan		

21, Church View, Cavan
T +353 49 43 61096
F +353 49 43 62907
E info@wggarchitects.ie
W www.wggarchitects.ie

